



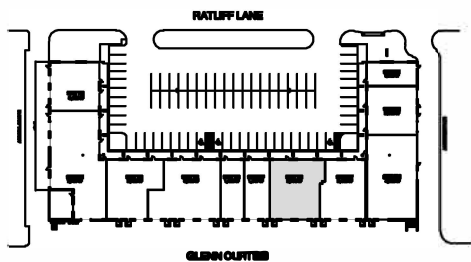

Z PROJECTS, LLC  
 1717 MCKINNEY AVE.  
 STE 700  
 DALLAS, TX 75202  
 214-912-6200  
 www.ZPROJECTS.com

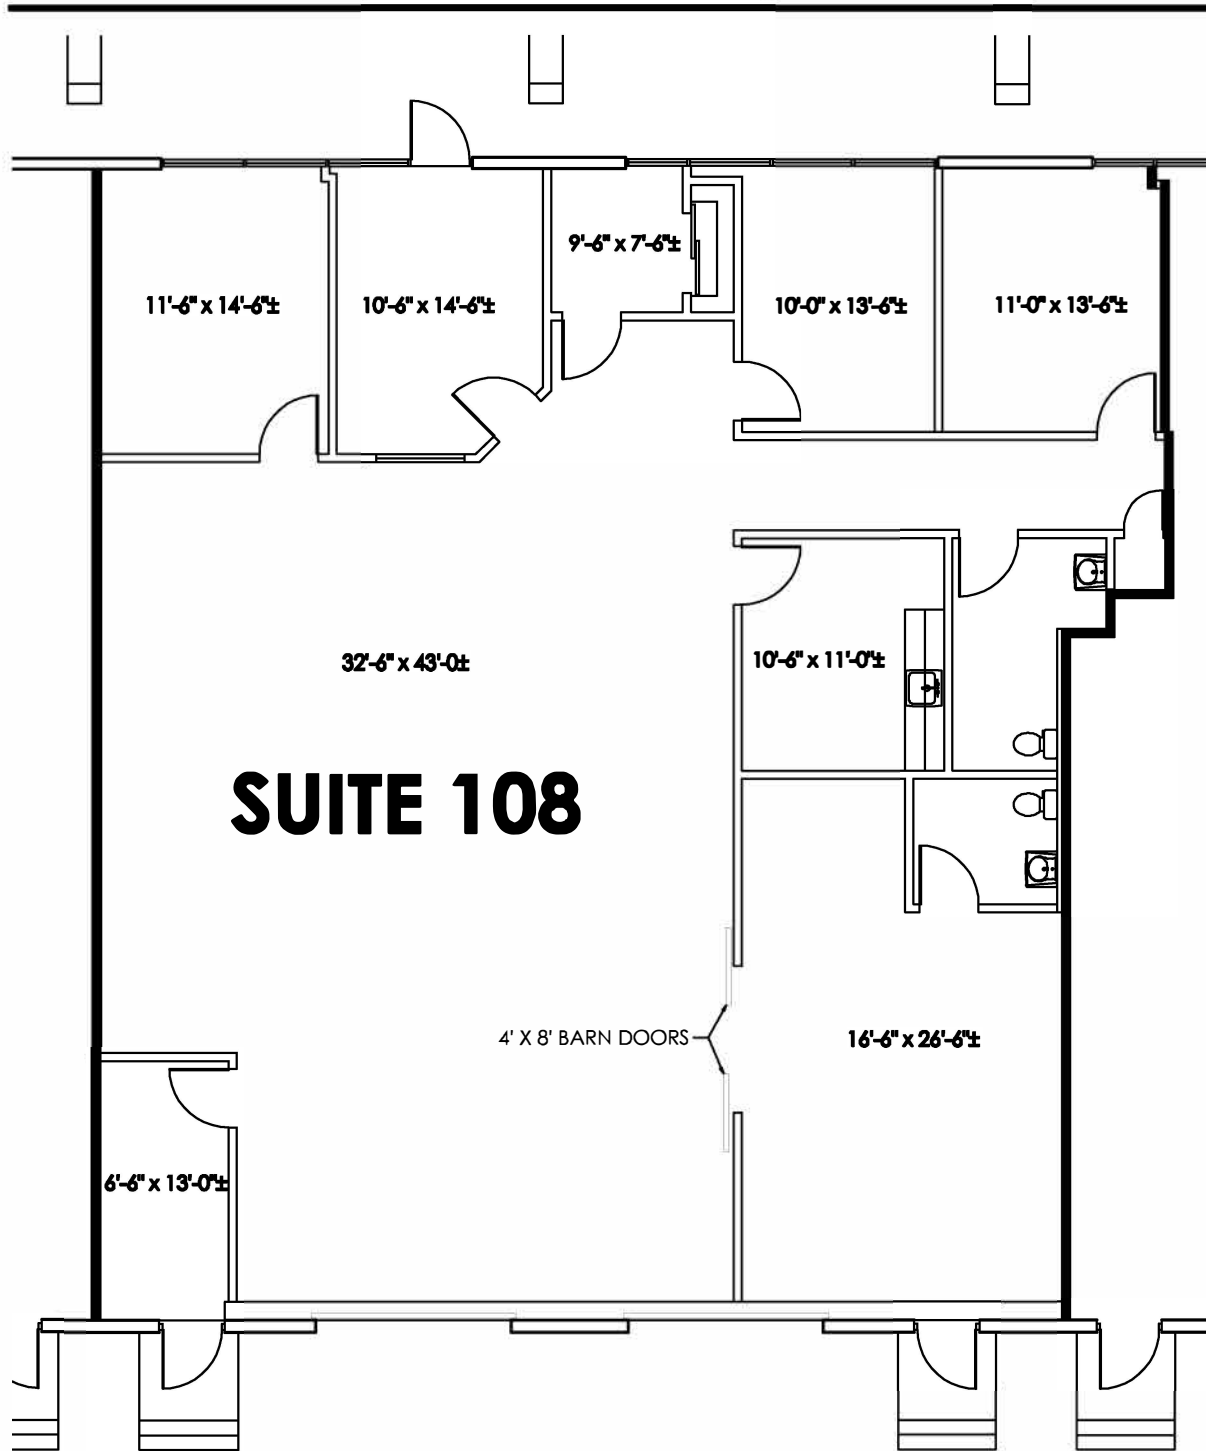

ROBERT B. POWELL, CCIM  
 POWELL REALTY ADVISORS, LLC.  
 214-908-3488  
 Robert.Powell@PowellRealtyAdvisors.com

**AIRPORT PLAZA**  
 SUITES 108 | 3,270 SF  
 4500 RATLIFF | ADDISON, TX 75001

**AS BUILT**

02.03.2020