



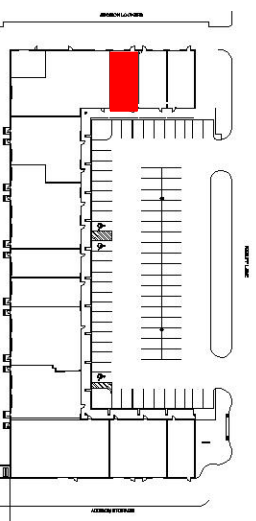

Z PROJECTS, LLC
1413 JACKSON RD.
KELLER, TX 76262
817.375.1506
www.zprojects.com/tx/denverwchh

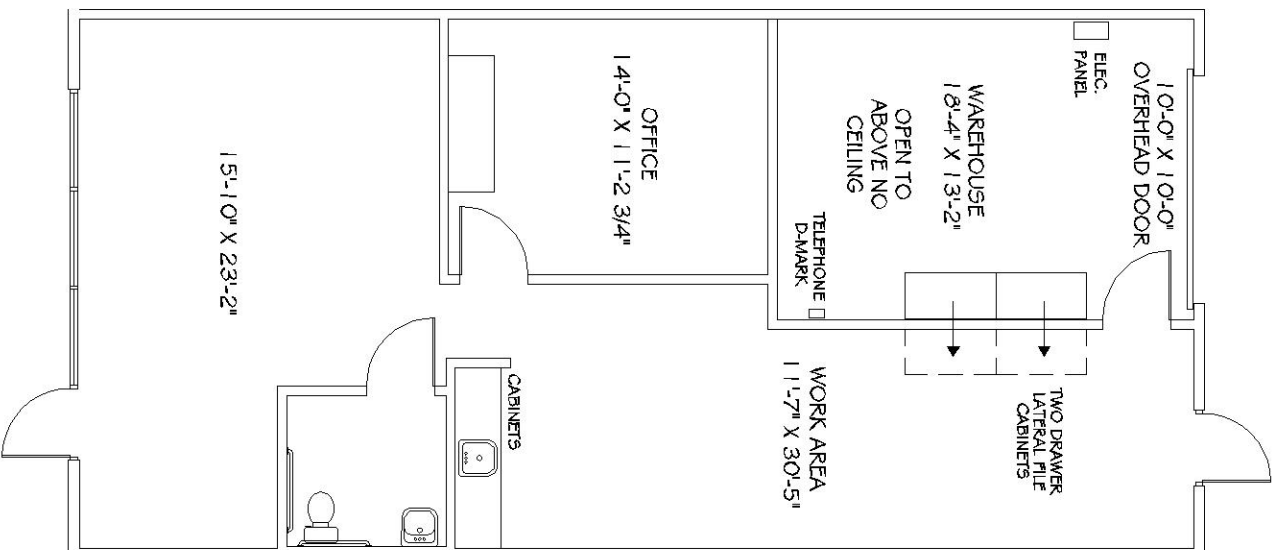

ROBERT B. POWELL, CCIM
POWELL REALTY ADVISORS, LLC,
214-908-3488
Robert.Powell@PowellRealtyAdvisors.com

AIRPORT PLAZA
SUITE 117 | 1,200 SF
4500 RALPH | ADDISON, TX 75001

AS BUILT
11.05.2025

